



ITEM	QTY	MEMBER DESIGNATION	MATERIAL GRADE	LENGTH (in)
1	2	W6x20	SA-36 / 44W	108"
2	4	W6x20	SA-36 / 44W	101 11/16"
3	2	W6x20	SA-36 / 44W	190"
4	2	W6x20	SA-36 / 44W	43"
5	1	W6x20	SA-36 / 44W	89 11/16"
6	1	PIPE NPS 3" SCH XH	SA-106-B	95"
7	1	PIPE NPS 3" SCH XH	SA-106-B	21 1/2"
8	2	HSS 4x4x1/4	SA-36 / 44W	89 11/16"

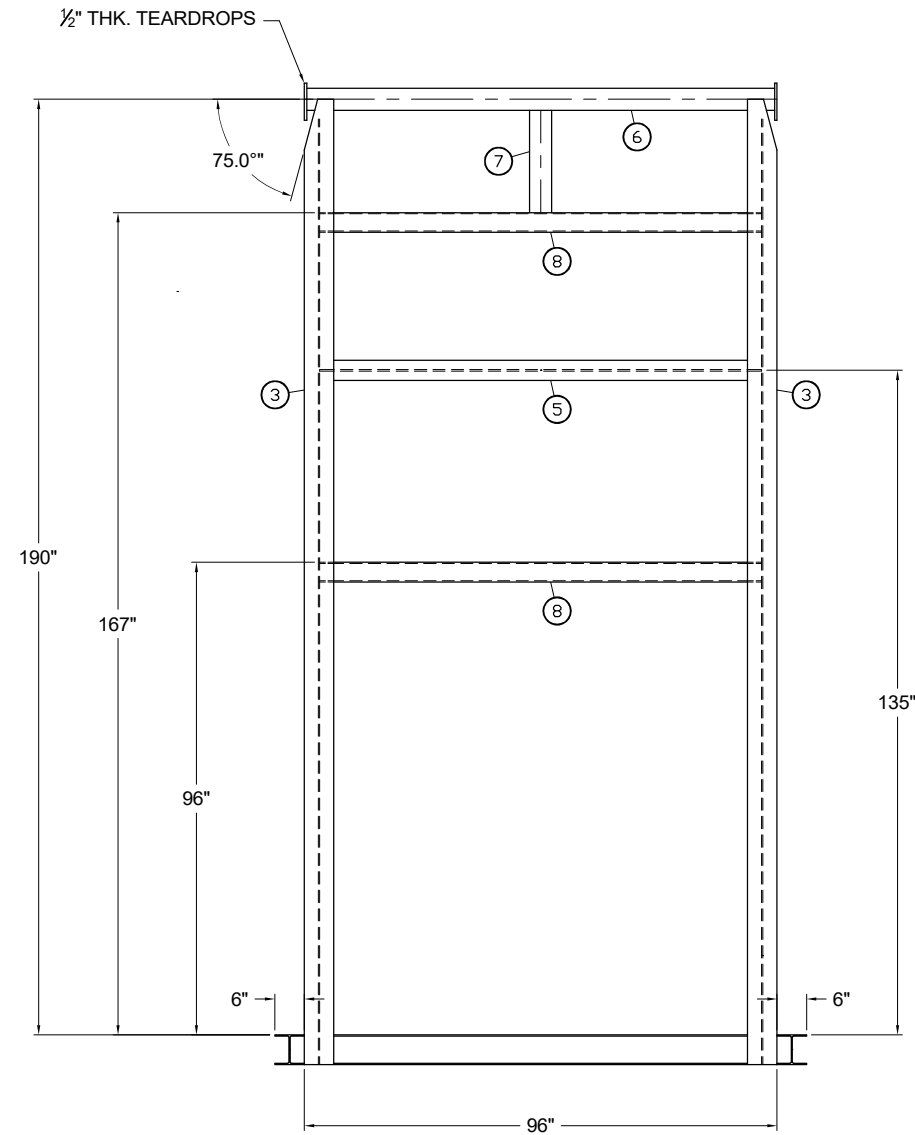

VIEW 'A-A'

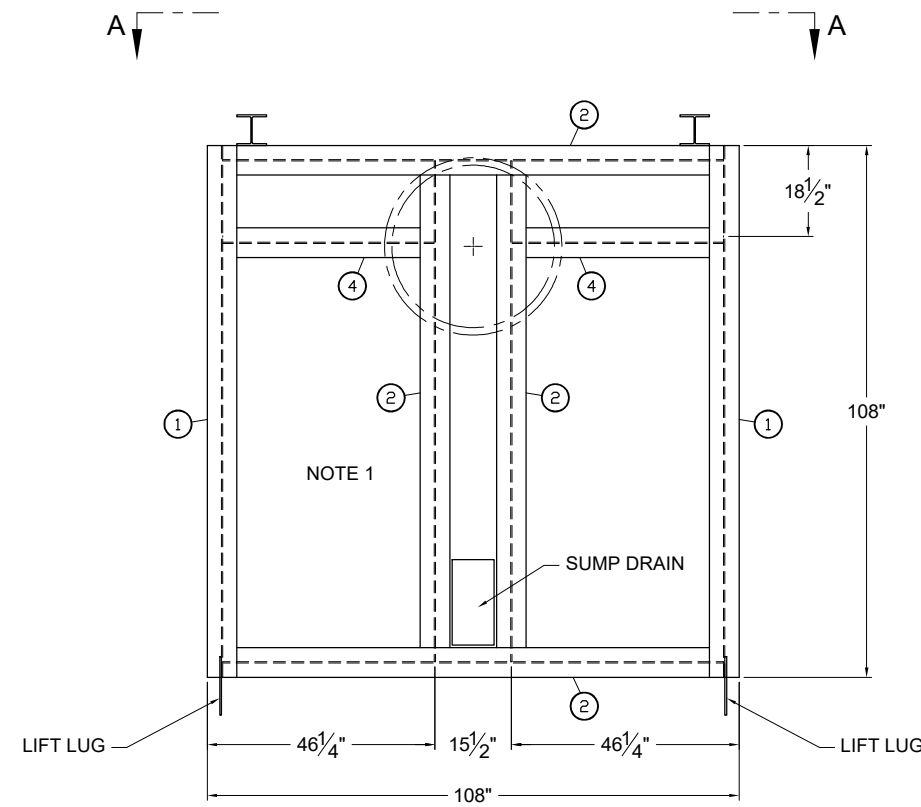

PLAN VIEW

NOTES:  
1. MAIN MEMBERS SHOWN ONLY.

NO.	DATE	REVISION	BY	APP
0	24-03-28	AS BUILT	MC	WS



**OTG OILFIELD EQUIPMENT LTD.**  
53 BURNT LAKE CRESCENT  
Red Deer, AB, T4S 0K6  
PHONE: (825)-221-9500

<b>JOB NO: 1046</b>			
36" OD x 10'-0" S/S VERTICAL SEPARATOR PKG SKID DETAILS			
DRAWN: MC	DATE: 24-03-28	CHECKED:	DATE:
APPROVED:	DATE:	SCALE: NTS	SHEET: 1 OF 1
UNIT#: OTG-1046	DWG NO: 1046-03	REV. 0	