


SKID LIMITS

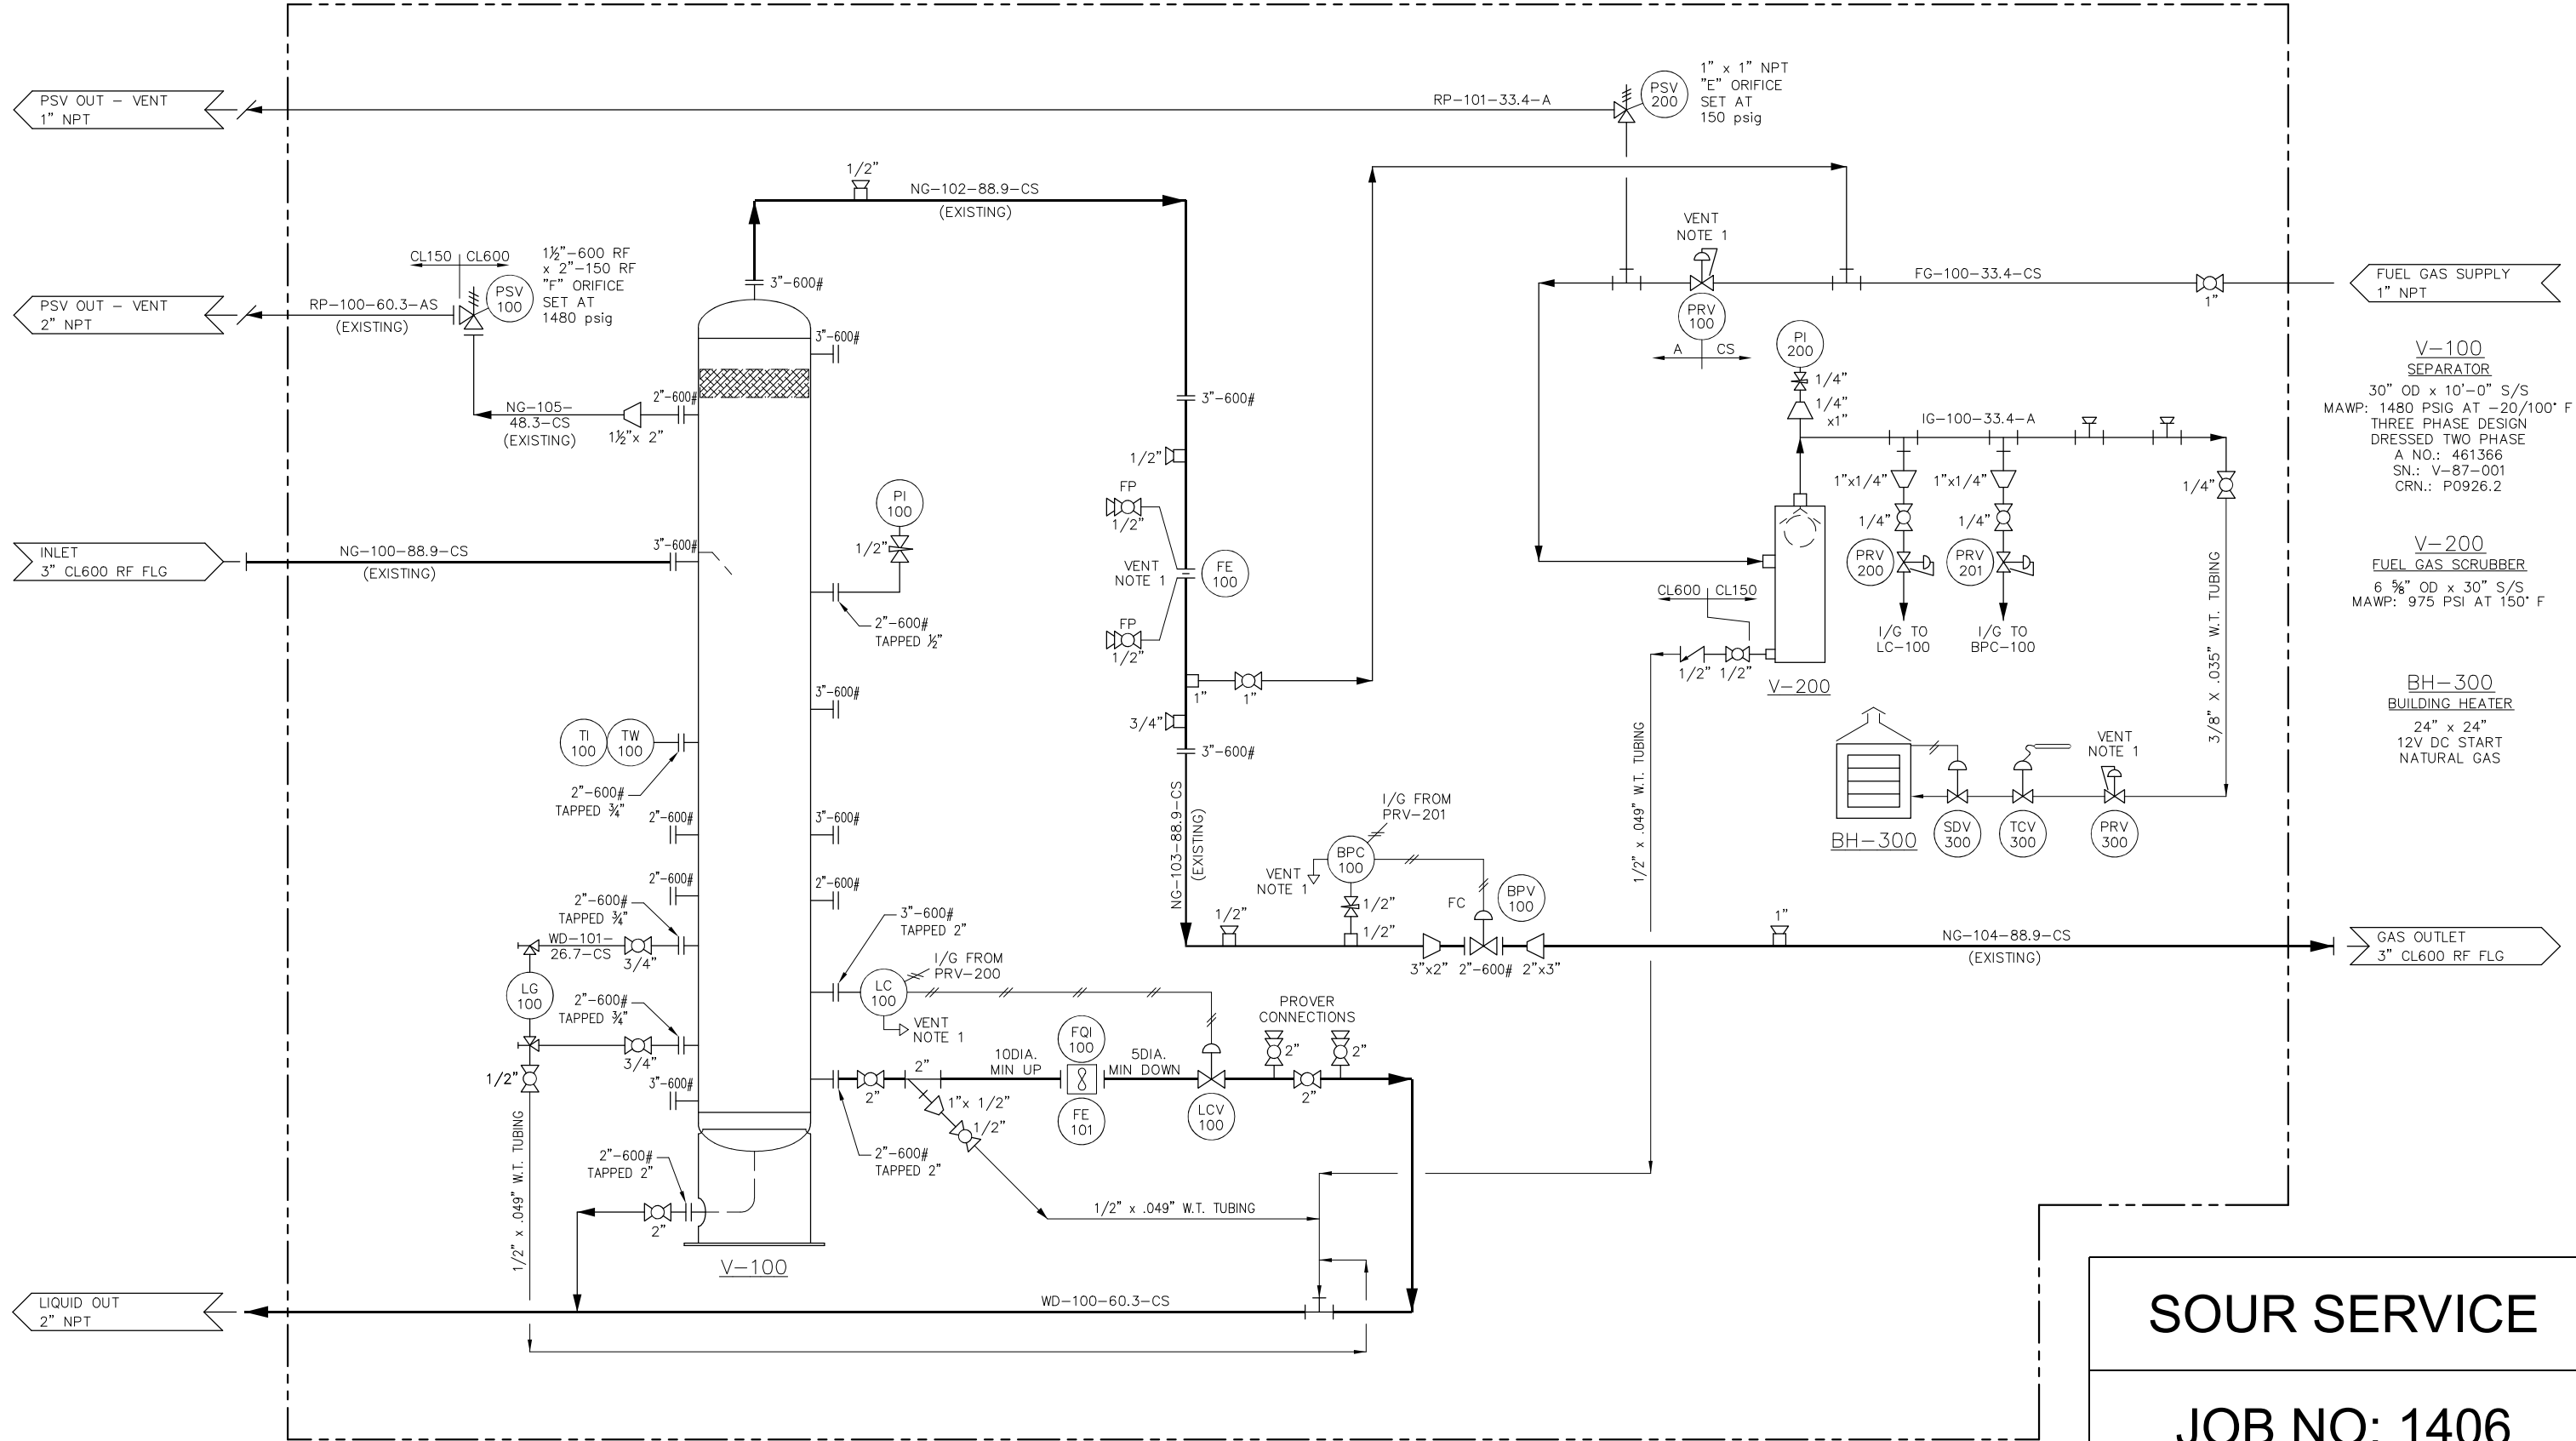

V-100
SEPARATOR
30" OD x 10'-0" S/S
MAWP: 1480 PSIG AT -20/100' F
THREE PHASE DESIGN
DRESSED TWO PHASE
A NO.: 461366
SN.: V-87-001
CRN.: P0926.2

V-200
FUEL GAS SCRUBBER
6 7/8" OD x 30" S/S
MAWP: 975 PSI AT 150' F

BH-300
BUILDING HEATER
24" x 24"
12V DC START
NATURAL GAS

SOUR SERVICE

JOB NO: 1406

NOTES:
1. INSTRUMENTS TO BE VENTED TO ATMOSPHERE.

NO.	DATE	REVISION	BY	APP
1	24-03-19	AS BUILT	MC	WS
0	24-02-15	ISSUED FOR CONSTRUCTION	MC	WS



OTG OILFIELD EQUIPMENT LTD.
53 BURNT LAKE CRESCENT
Red Deer, AB, T4S 0K6
PHONE: (825)-221-9500

30" OD x 10'-0" S/S 1440 PSI VERTICAL SEPARATOR PKG PROCESS & INSTRUMENTATION DIAGRAM			
DRAWN: MC	DATE: 24-02-15	CHECKED:	DATE:
APPROVED:	DATE:	SCALE: NTS	SHEET: 1 OF 1
UNIT#: OTG-1406	DWG NO: 1406-01	REV: 1	